HR Green, Inc. Project No. 10110158 1st Street Water Main Replacement From Liberty St to Chestnut St Wilton, Iowa ADDENDUM #2

# 1<sup>ST</sup> STREET WATER MAIN REPLACEMENT FROM LIBERTY ST TO CHESTNUT ST WILTON, IOWA

CONTRACTOR'S BID DATE: Wednesday, June 21, 2023 @ 2:00 P.M.

PLACE FOR CONTRACTORS

TO SUBMIT BIDS: City of Wilton City Hall

104 E. 4<sup>th</sup> Street Wilton, Iowa 52778

#### **ADDENDUM NO.2**

June 14, 2023

#### TO ALL PLANHOLDERS:

The following changes, clarifications, additions, and/or deletions are hereby made a part of the contract documents for the above-referenced project, as fully and completely as if the same were fully set forth therein. All Bidders submitting a Bid on the above Contract shall carefully read this Addendum and give it consideration in the preparation of their Bid.

This Addendum No. 2 consists of the following:

- Addendum No. 2 (pages ADN2-1 through ADN2-2)
- Section 00400 BID FORM ADDENDUM 2 (4 pages)
- Plan Sheet G001 (1 page)
- Plan Sheet C101 (1 page)

#### **CLARIFICATIONS:**

1. No Soil Information is available.

#### **SPECIFICATIONS:**

- 1. REFER TO SECTION 00200 INSTRUCTIONS TO BIDDERS
  - a. **CHANGE** the diameter of the casing pipe in Bid Item 2 diameter from "18" to "14".
- 2. REFER TO SECTION 00400 BID FORM
  - a. **REPLACE** the Bid Form with the attached.

## **PLANS:**


- 1. REFER TO SHEET G001
  - a. **REPLACE** with the attached.

June 14, 2023 ADN2 - 1

### 2. REFER TO SHEET C101

a. REPLACE with the attached.

All bidders shall acknowledge receipt and acceptance of Addendum No. 2 by signing in the space provided on the Bid Form. Bids submitted without Addendum No. 2 being acknowledged will be considered non-responsive.

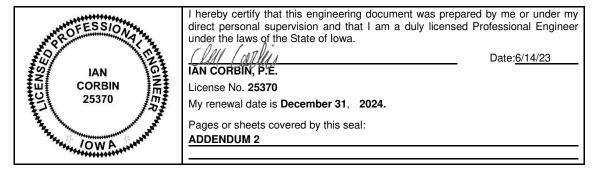

IAN CORBIN, PE HR GREEN, INC. 8710 EARHART LANE CEDAR RAPIDS, IOWA 52404 PHONE: (319) 841-4000

**END OF ADDENDUM #2** 

June 14, 2023 ADN2 - 2

## SECTION 00400 BID FORM ADDENDUM 2

BID TO: City of Wilton
104 E. 4th Street
Wilton, Iowa

1. The undersigned Bidder proposes and agrees, if this Bid is accepted, to enter into an Agreement with the Owner in the form included in the Contract Documents to perform the WORK as specified or indicated in said Contract Documents entitled:

### 1st Street Water Main Replacement From Liberty St to Chestnut St

- 2. Bidder accepts all of the terms and conditions of the Contract Documents, including without limitation those in the Notice to Bidders and Instructions to Bidders, dealing with the disposition of the Bid Security.
- 3. Schedule of prices for construction of <u>1st Street Water Main Replacement From Liberty St to Chestnut St</u> in accordance with the Contract Documents.

ITEM NO.	ITEM DESCRIPTION	UNIT	QUANTIT Y	UNIT PRICE	TOTAL
1	WATER MAIN, TRENCHED, PVC DR 18, 6-INCH – CITY WILL PROCURE PIPE	LF	2,210	\$	\$
2	WATER MAIN WITH 14" STEEL CASING PIPE, TRENCHLESS, PVC, 6" – THE CITY WILL PROCURE PVC AND STEEL PIPE, CASING SPACERS, CASING END SEALS	LF	70	\$	\$
3	WATER MAIN FITTINGS, BEND, 6" DI MJ, 90 DEG – THE CITY WILL PROCURE 90 DEGREE BENDS	EA	3	\$	\$
4	WATER MAIN FITTINGS, REDUCER, 6" X 4" – THE CITY WILL PROCURE REDUCER	EA	1	\$	\$
5	WATER SERVICE STUB – THE CITY WILL PROCURE SERVICE LINES OF A LENGTH NEEDED TO REACH THE STOP BOX, TO BE FIELD VERIFIED	EA	26	\$	\$

ITEM NO.	ITEM DESCRIPTION	UNIT	QUANTIT Y	UNIT PRICE	TOTAL
6	WATER MAIN ABANDONMENT, CAP, 4" – THE CITY WILL PROCURE CAP	EA	1	\$	\$
7	WATER MAIN ABANDONMENT, CAP, 8" – THE CITY WILL PROCURE CAP	EA	1	\$	\$
8	WATER MAIN ABANDONMENT, FILL AND PLUG, 4" – THE CITY WILL PROCURE PLUGS	LF	2,198	\$	\$
9	GATE VALVE, 6" DI MJ – THE CITY WILL PROCURE VALVES	EA	2	\$	\$
10	INSERTION VALVE, 8" – THE CITY WILL PROCURE INSERTION VALVE	EA	1	\$	\$
11	INSERTION VALVE, 4" – THE CITY WILL PROCURE INSERTION VALVE	EA	1	\$	\$
12	TAPPING VALVE ASSEMBLY, 8"X6" – THE CITY WILL PROCURE TAPPING VALVE ASSEMBLY	EA	1	\$	\$
13	TAPPING VALVE ASSEMBLY, 4"X4" – THE CITY WILL PROCURE TAPPING VALVE ASSEMBLY	EA	1	\$	\$
14	FIRE HYDRANT ASSEMBLY – THE CITY WILL PROCURE HYDRANT ASSEMBLIES	EA	7	\$	\$
15	FIRE HYDRANT ASSEMBLY REMOVAL	EA	3	\$	\$
16	VALVE REMOVAL	EA	2	\$	\$
17	SEAL COAT ROAD RESTORATION	SY	2,507	\$	\$
18	TEMPORARY TRAFFIC CONTROL	LS	1	\$	\$
19	CONSTRUCTION SURVEY	LS	1	\$	\$
20	MOBILIZATION	LS	1	\$	\$
21	6" GRANULAR SURFACING	TONS	790	\$	\$

1st Street Water Main Replacement From Liberty St to Chestnut St Wilton, Iowa

						Wilton, Iowa
	ITEM NO.	ITEM DESCRIPTION	UNIT	QUANTIT Y	UNIT PRICE	TOTAL
	TOTAL ITEM 1 THROUGH 21 \$					
4.	. Name of person who inspected site of proposed WORK for your firm:					

4.	Name of p	person who inspected	site of proposed	WORK for your firm:
		Name:		Date of Inspection:
5.		s examined copies of f all of which is hereby		Documents including the following addenda
	Number		Date _	
6.	rejection. WORK, s state and progress	Bidder has familiarize ite, locality where the local laws, ordinance	ed itself with the na WORK is to be ples, rules and reg	ne Bid non-responsive and be cause for its ature and extent of the Contract Documents, performed, the legal requirements (federal, ulations), and the conditions affecting cost, is made such independent investigations as
7.		er hereby agrees to co n this proposal and ide		ditional requirements listed below which are rm attachments:
ITE	M NO.	DESCRIPTION OF A	TTACHMENT	
		1. 2.	Transact Busine	Form and Worksheet: Authorization to ess  – Bid Bond (Submitted in Separate Sealed
to stip	complete to a complete to the	the WORK required	under the Contr nts, and to accept	rained in this Bid, said Bidder further agrees ract Documents within the Contract Time in full payment therefore the Contract Price entioned Bid Form.
Sig	ned this	day of _		, 2023.
			Ву:	
				(Firm Name)
				(Signature)

		(Typed o	r Printed Name)
			(Title)
(1)	BIDDER's name and address:		
(2)	BIDDER's telephone numbers, and	e-mail address:	
(3)	Federal Tax I.D. No.:	Iowa Cor	ntractor License No.:
	(DO N	IOT OMIT)	
(4)	BIDDER's authorized agent for con	tract execution:	Name and Title
(5)	BIDDER's attesting agent for contra	act execution:	Name and Title
(6)	BIDDER's type of business:		
		(Corporation, pa	rtnership, individual, etc.)

END OF SECTION 00400

		ESTIMATE REFERENCE INFORMATION	]
REFER TO THI		SPECIFICATIONS (2021 EDITION) FOR INFORMATION ON THE FOLLOWING BID ITEMS. COMPLETE ALL WORK AS SHOWN ON THE PLANS. IN CASE WHERE THERE IS NO BID ITEM FOR THE WORK, CONSIDER THE WORK INCIDENTAL TO OTHER BID ITEMS.	
ITEM NO.	ITEM CODE	DESCRIPTION	_
1	5010-A-1	WATER MAIN, TRENCHED, PVC DR 18, PUSH-ON JOINT, 6-INCH	
	*******	A. BACKFILL MATERIAL MAY BE MATERIAL EXCAVATED FROM THE TRENCH AS LONG AS SUDAS SUITABLE BACKFILL REQUIREMENTS ARE MET. CONTRACTOR IS RESPONSIBLE FOR THE TRENCH COMPACTION TESTING PER SUDAS 3010. 12" STORM SEWER IS INCIDENTAL. CONTRACTOR IS REQUIRED TO FIELD VERIFY EXISTING PIPE TYPE PRIOR TO ORDERING MATERIALS AND CONSTRUCTION FOR THIS WORK. CONTRACTOR IS RESPONSIBLE FOR STORM SEWER PIPE.	
2	5010-B-2	WATER MAIN WITH 14" STEEL CASING PIPE, TRENCHLESS, PVC, 6"	] )
		A. SUDAS SECTION 3020 FOR TRENCHLESS CONSTRUCTION SHALL BE FOLLOWED.	Υ_
		B. THIS ITEM SHALL INCLUDE BUT IS NOT LIMITED TO THE FOLLOWING: RESTRAINED JOINT C900 PVC CARRIER PIPE, 14" STEEL CASING PIPE WITH MINIMUM WALL THICKNESS OF 3/8", CASING SPACERS WITH A MAXIMUM OF 6' SPACING, CASING END SEAL AND TRENCHLESS INSTALLATION.	
3	5010-C-1	WATER MAIN FITTINGS, BEND, 6" DI MJ, 90 DEG	
		A. RESTRAINED ALL FITTINGS USING DUCTILE IRON RETAINING GLANDS; MEGALUG SERIES 110 OR 2000 PV, STARGRIP SERIES 3000 OR 4000 OR APPROVED EQUIVALENT.	
		B. ALL DUCTILE IRON FITTINGS SHALL BE WRAPPED IN POLYETHYLENE ENCASEMENT. POLY-WRAP SHALL BE CONSIDERED INCIDENTAL.	1
4	5010-C-1	WATER MAIN FITTINGS, REDUCER, 6"X4"	1
5	5010-D	WATER SERVICE STUB	1
		A. SERVICE SIZE AND LENGTH TO BE FIELD VERIFIED. DIFFERENT SERVICE SIZES WILL NOT BE COUNTED SEPARATELY. MATCH THE EXISTING DIAMETER ON ALL SERVICE PIPES WITH THE NEW SERVICE LINE. THIS ITEM SHALL INCLUDE ANY AND ALL MATERIALS AND WORK TO CONNECT TO THE EXISTING SERVICE LINE. USE TYPE K COPPER PIPE. CITY WILL PROCURE SERVICE LINES.	
6	5010-F	WATER MAIN ABANDONMENT, CAP, 4"	
7	5010-F	WATER MAIN ABANDONMENT, CAP, 8"	
8	5010-G	WATER MAIN ABANDONMENT, FILL AND PLUG, 4"	
		A. EXISTING 4" MAIN SHALL REMAIN ACTIVE THROUGHOUT NEW WATER MAIN INSTALLATION	
9	5020-A	GATE VALVE, 6" DI MJ	
		A. PROVIDE VALVE BOX ADAPTOR ii FOR ALL BURIED VALVES.	
		B. RESTRAIN ALL VALVES USING DUCTILE IRON RETAINING GLANDS, SEE WATER MAIN FITTINGS ITEM ABOVE.	
10	5020-A	INSERTION VALVE 8"	
11	5020-A	INSERTION VALVE 4"	
		A. MANUFACTURER TO BE QUIKVALVE BY ROMAC OR EQUAL	1 🖄
12	5020-B	TAPPING VALVE ASSEMBLY, 8"X6"	
13	5020-B	TAPPING VALVE ASSEMBLY, 4"X4"	1
14	5020-C	FIRE HYDRANT ASSEMBLY	]
		A. HYDRANT ASSEMBLY SHALL BE FULLY RESTRAINED USING ANCHOR TEE AND PIPE AS IDENTIFIED IN SUDAS FIGURE 5020.201 (WM-201) OR WITH MJ FITTINGS AND DUCTILE IRON RETAINING GLANDS, SEE WATER MAIN FITTINGS ABOVE. HYDRANT TEE IS INCLUDED AS PART OF HYDRANT ASSEMBLY BID ITEM.	
		B. FIRE HYDRANT SHALL BE PROVIDED WITH 5-1/4" MAIN VALVE, (1) 4-1/2" PUMPER NOZZLE, AND (2) 2-1/2" HOSE NOZZLES. PROVIDE NATIONAL STANDARD NOZZLE THREADS.	
		C. AUXILIARY VALVE SHALL MEET REQUIREMENTS FOR GATE VALVE, SEE REQUIREMENTS ABOVE.	1
		D. PROVIDE GRAVEL PACK, TRACE WIRE AND F TRACER WIRE TERMINAL POST. INCLUDE ANCILLARY COMPONENTS TO PROVIDE A COMPLETE FIRE HYDRANT ASSEMBLY.	
		E. HYDRANT SHALL BE WATEROUS PACER, CLOW MEDALLION, EJ WATERMASTER, AND KENNEDY GUARDIAN.	-
15	5020-J	FIRE HYDRANT ASSEMBLY REMOVAL	-
		A. SALVAGE FIRE HYDRANT TO OWNER.	1
16	5020-K	VALVE REMOVAL	1
		A. REMOVE VALVE BOXES ON ABANDONED WATER MAIN AFTER NEW WATER MAIN HAS BEEN PUT IN SERVICE.	1
17	7060-A	SEAL COAT ROAD RESTORATION	-
18	8030-A	TEMPORARY TRAFFIC CONTROL	1 ^
		A. SUBMIT STREET/LANE CLOSURE TO OWNER FOR REVIEW AND APPROVAL A MINIMUM OF 48 HOURS PRIOR TO CLOSURE.	] <u>î</u>


19	11010-A-0	CONSTRUCTION SURVEY
		A. ITEM INCLUDES ALL SURVEY AND STAKING WORK AS NECESSARY FOR CONSTRUCTION OF THE PROJECT AS INTENDED BY THE CONTRACT DOCUMENTS.
		B. THE CONTRACTOR SHALL BE RESPONSIBLE FOR MAINTAINING ALL HORIZONTAL AND VERTICAL CONTROL WITHIN THE PROJECT LIMITS FOLLOWING COMPLETION OF THE CONSTRUCTION ACTIVITIES.
		C. ANY PROPERTY PINS DISTURBED BY THE CONTRACTOR SHALL BE RE-ESTABLISHED BY A LICENSED SURVEYOR.
		D. CONTRACTOR SHALL SUPPLY OWNER WITH TWO (2) HARD COPIES OF PROJECT RECORD DRAWINGS.
20	11020-A-0	MOBILIZATION
		A. SEE SUDAS SECTION 11020 FOR PROGRESS PAYMENTS FOR MOBILIZATION.
		B. AT LEAST ONE (1) WEEK PRIOR TO CONSTRUCTION ACTIVITIES WITHIN PUBLIC RIGHT-OF-WAY AND/OR EASEMENTS, CONTRACTOR SHALL CONTACT OWNER TO OBTAIN APPLICABLE CITY PERMITS.
21	7030-108-H-3	GRANULAR SURFACING 6"
		A. TO BE PLACED PRIOR TO SEAL COAT PER SUDAS 7030-108-H-3. QUANTITY IS FOR NEW ROCK ONLY AND FOR BIDDING PURPOSES ONLY. SALVAGED ROCK FROM EXISTING ROAD SURFACES MAY BE REUSED BUT IS CONSIDERED INCIDENTAL.

		ESTIMATED QUANTITIES			
ITEM NO.	ITEM CODE	ITEM DESCRIPTION	UNIT	PLAN QUANTITY	AS BUILT QUANTITY
~_t~~	√5010-A-1∕	WATER MAIN, TRENCHED, PVC DR-18, 6-INCH	~tF~	~2,210~	~~~~~
2	5010-B-2	WATER MAIN WITH 14" STEEL CASING PIPE, TRENCHLESS, PVC, 6"	LF	70	
~3~	<u>√5010-€-1</u> ~	WATER-MAIN-FITTINGS, BEND, 6"DI-MI, 90-DEG	^ÉÀ^	~~~~	
4	5010-C-1	WATER MAIN FITTINGS, REDUCER, 6"X4"	EA	1	
5	5010-D	WATER SERVICE STUB	EA	26	
6	5010-F	WATER MAIN ABANDONMENT, CAP, 4"	EA	1	
7	5010-F	WATER MAIN ABANDONMENT, CAP, 8"	EA	1	
8	5010-G	WATER MAIN ABANDONMENT, FILL AND PLUG, 4"	LF	2,198	
9	5020-A	GATE VALVE, 6" DI MJ	EA	2	
10	5020-A	INSERTION VALVE, 8"	EA	1	
11	5020-A	INSERTION VALVE, 4"	EA	1	
12	5020-B	TAPPING VALVE ASSEMBLY, 8"X6"	EA	1	
13	5020-B	TAPPING VALVE ASSEMBLY, 4"X4"	EA	1	
14	5020-C	FIRE HYDRANT ASSEMBLY	EA	7	
15	5020-J	FIRE HYDRANT ASSEMBLY REMOVAL	EA	3	
16	5020-K	VALVE REMOVAL	EA	2	
17	7060-A	SEAL COAT ROAD RESTORATION	SY	2,507	
18	8030-A-0	TEMPORARY TRAFFIC CONTROL	LS	1	
19	11010-A-0	CONSTRUCTION SURVEY	LS	1	
20	11020-A-0	MOBILIZATION	LS	1	
21	7030-108-H-3	GRANULAR SURFACING 6"	TONS	790	

DRAWN BY:	JWJ	JOB DATE:	2022	BAR IS ONE INCH ON OFFICIAL DRAWINGS.
APPROVED:	IMC	JOB NUMBER:	10110158	01"
CAD DATE:	6/14/2023	10:43:24 AM		IF NOT ONE INCH, ADJUST SCALE ACCORDINGLY
CAD FILE:	\\hracrnas\	.Data\10110158\	1stStreetWaterMain\	Design\DWGs\G001dwa

	ı	NO.	DATE	BY	REVISION DESCRIPTION
	ı	1	6/12/23	I.C	ADDENDUM 1
	ı	2	6/14/23	I.C	ADDENDUM 2
.	ı				
┙	ı				



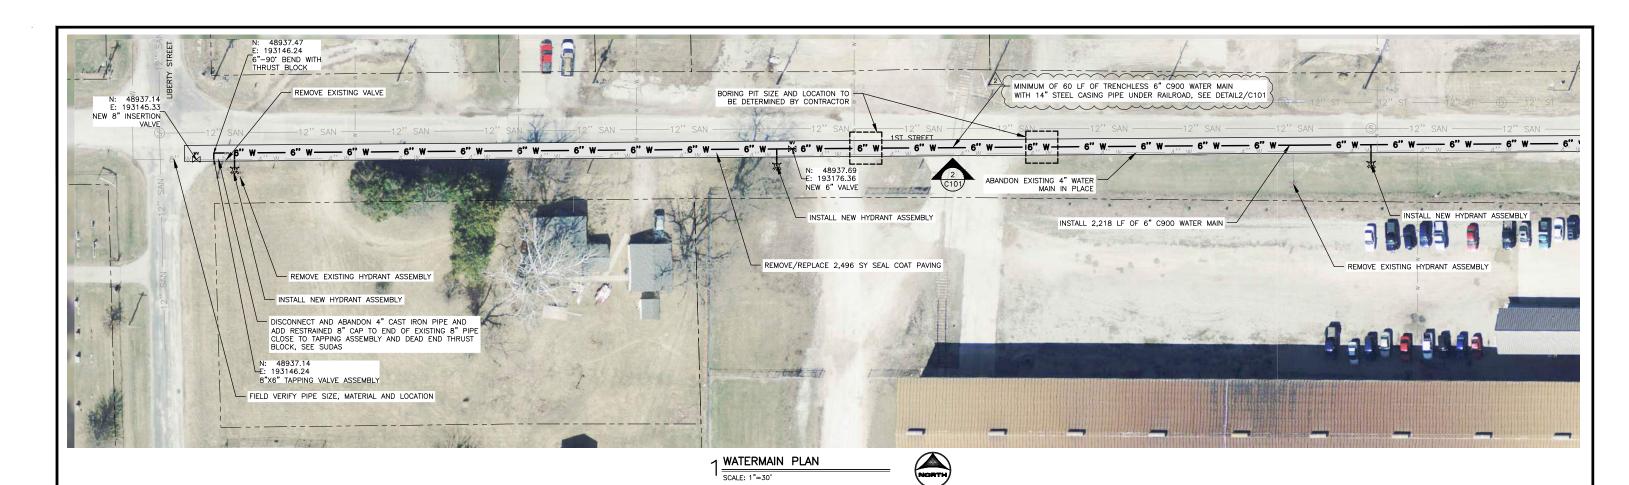

CL OF RR CARRIER PIPE CASING PIPE

 $2\frac{\text{CASING PIPE DETAIL}}{\text{SCALE: NONE}}$ 

DRAWN BY: BDB

APPROVED: IMC

JOB DATE: <u>2022</u>

JOB NUMBER: 10110158

BAR IS ONE INCH ON OFFICIAL DRAWINGS. NO. DATE BY REVISION DESCRIPTION 1 6/14/23 CAD DATE: 6/14/2023 11:46:19 AM IF NOT ONE INCH, ADJUST SCALE ACCORDINGLY.

CAD FILE: \hrgcrnas\Data\10110158\1stStreetWaterMain\Design\DWGS\WATER MAIN



GENERAL NOTES

1. ABANDON EXISTING PIPE IN PLACE.
2. MINIMUM 5' COVER OVER TOP OF PIPE.
3. RESTRAINED JOINT 10' FROM ALL VALVES AND FITTINGS.
4. PROTECT EXISTING SANITARY SEWER SERVICES.
5. FIELD VERIFY EXISTING WATER MAIN DEPTH.
6. RECONNECT ALL EXISTING WATER SERVICE STUBS. FIELD VERIFY ALL SERVICE LOCATIONS.
7. PROTECT CURB.
8. REMOVE AND REPLACE PCC SIDEWALK AND DRIVEWAYS AS NEEDED.
9. REMOVE AND REPLACE GRAVEL ROAD AND DRIVEWAYS AS NEEDED.
10. TREE REMOVAL, SEEDING, STORM SEWER, SIDEWALK AND DRIVEWAY REMOVAL AND REPLACEMENT, AND STORM SEWER INLET PROTECTION ARE INCIDENTAL TO PROJECT, REFER TO SUDAS 2022.
11. EXISTING 4" MAIN SHALL REMAIN ACTIVE THROUGHOUT NEW WATER **LEGEND** EXISTING HYDRANT PROPOSED HYDRANT EXISTING VALVE PROPOSED VALVE 11. EXISTING 4" MAIN SHALL REMAIN ACTIVE THROUGHOUT NEW WATER MAIN INSTALLATION. EXISTING WATER 12. NEW 6" WATER MAIN AND SERVICES TO REMAIN ACTIVE WHILE DISCONNECTING AND ABANDONING THE 4" WATER MAIN. -12" SAN - EXISTING SANITARY — 12" ST — EXISTING STORM EXISTING SANITARY MANHOLE EXISTING STORM MANHOLE EXISTING STORM INTAKE 6" W ---- PROPOSED WATER WATER SERVICE SHUT OFF

1ST STREET WATER MAIN REPLACEMENT FROM LIBERTY ST TO CHESTNUT ST CITY OF WILTON WILTON, IOWA

CIVIL

1ST ST WATERMAIN PLAN

SHEET NO. C101

WATER SERVICE