Division Street Shared Use Path Wilton, Iowa ADDENDUM #1

## DIVISION STREET SHARED USE PATH WILTON, IOWA

CONTRACTOR'S BID DATE: Wednesday, February 21, 2024 @ 1:00 P.M.

PLACE FOR CONTRACTORS

TO SUBMIT BIDS: City of Wilton City Clerk

104 East 4<sup>th</sup> Street Wilton, IA 52778

#### **ADDENDUM NO.1**

February 7, 2024

#### **TO ALL PLANHOLDERS:**

The following changes, clarifications, additions, and/or deletions are hereby made a part of the contract documents for the above-referenced project, as fully and completely as if the same were fully set forth therein. All Bidders submitting a Bid on the above Contract shall carefully read this Addendum and give it consideration in the preparation of their Bid.

This Addendum No. 1 consists of the following:

- Addendum No. 1 (pages ADN1-1 through ADN1-2)
- Proposal ADDENDUM 1 (6 pages)
- Plan Sheets (4 pages)

#### **SPECIFICATIONS:**

#### 1. REFER TO PROPOSAL

a. REPLACE the PROPOSAL with the attached PROPOSAL – ADDENDUM 1.
 NOTE: the updated bid item list and quantity highlighted.

#### 2. REFER TO CONTRACT

- a. **CHANGE** Bid Item Quantity from "1,498" to "1,508".
- b. **ADD** Bid Item 28. "Special Subbase Preparation".


#### **PLAN DRAWING ITEM(S):**

Remove and replace the following plan sheets. A brief description of the changes on each sheet is provided for clarification.

1. Sheet A.01 a revisions tracking table has been added to this sheet with this addendum listed in the table.

February 7, 2024 ADN1 - 1

- 2. Sheet B.01 the typical sections have been updated to show the Special Subbase Preparation item along with a note regarding this item.
- 3. Sheet C.01 has updated the Estimated Project Quantities table to reflect the new bid item at quantity provided.
- 4. Sheet C.02 has rearranged the prior tabulations on the sheet and now includes the continuation of the Estimate Reference Information to its conclusion.

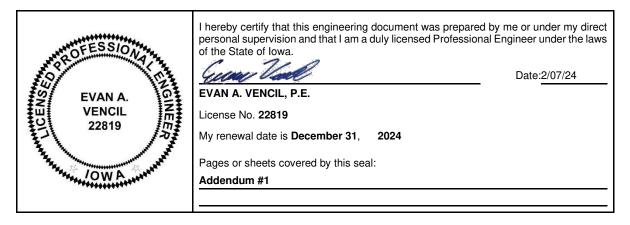

EVAN VENCIL, PE HR GREEN, INC. 8710 EARHART LANE CEDAR RAPIDS, IOWA 52404 PHONE: (319) 841-4000

**END OF ADDENDUM #1** 

February 7, 2024 ADN1 - 2

Division Street Shared Use Path Wilton, Iowa ADDENDUM #1

# PROPOSAL DIVISION STREET SHARED USE PATH WILTON, IOWA

#### **ADDENDUM 1**

PROPOSAL: PART A - SCOPE

The City of Wilton, hereinafter called the "Jurisdiction", has need of a qualified contractor to complete the work comprising the below referenced improvement. The undersigned Bidder hereby proposes to complete the work comprising the below referenced improvement as specified in the contract documents, which are officially on file with the Jurisdiction, in the office of the City Clerk at the prices hereinafter provided in Part C of the Proposal, for the following described improvements:

Approximately 1,400 linear feet of 10 feet wide trail constructed on the southside of E Division Street between Maurer Street and Cypress Street.

#### PROPOSAL: PART B - ACKNOWLEDGMENT OF ADDENDA

The Bidder hereby acknowledges that all addenda become a part of the contract documents when issued, and that each such addendum has been received and utilized in the preparation of this bid. The Bidder hereby acknowledges receipt of the following addenda by inserting the number of each addendum in the blanks below and certifies that said addenda were utilized in the preparation of this bid.

ADDENDUM NUMBER	ADDENDUM NUMBER
ADDENDUM NUMBER	ADDENDUM NUMBER

#### PROPOSAL: PART C - BID ITEMS, QUANTITIES AND PRICES

UNIT BID PRICE CONTRACTS: The Bidder must provide the Unit Bid Price, the Total Bid Price, any Alternate Prices and the Total Construction Costs on the Proposal Attachment: Part C – Bid Items, Quantities, and Prices. In case of discrepancy, the Unit Bid Price governs. The quantities shown on the Proposal Attachment: Part C – Bid Items, Quantities and Prices are approximate only, but are considered sufficiently adequate for the purpose of comparing bids. The Jurisdiction shall only use the Total Construction Cost for comparison of the bids. The Total Construction Cost, including any Add-Alternates shall be used for determining the sufficiency of the bid security.

BASE BID CONTRACTS: The bidder must provide any Bid Prices, and alternate Prices, and the Total of the Base Bid plus any Add-alternates on the Proposal Attachment: Part C-Bid Items, Quantities, and the Prices. The Jurisdiction shall only use the Total Construction Cost for comparison of the bids. The Total Construction Cost, including any Add-Alternates shall be used for determining the sufficiency of the bid security.

#### PROPOSAL: PART D - GENERAL

The Bidder hereby acknowledges that the Jurisdiction, in advertising for bids for this project reserves the right to:

- Reject any or all bids. Award of the contract, if any, to be to the lowest responsible, responsive bidder; and
- 2. Reject any or all alternates in determining the items to be included in the contract. Designation of the lowest responsible, responsive bidder to be based on the comparison of the total bid only, not including any alternates; and
- 3. Make such alterations in the documents or in the proposal quantities as it determines necessary in accordance with the contract documents after execution of the contract. Such alterations shall not be considered a waiver of any conditions of the contract documents, and shall not invalidate any of the provisions thereof; and

#### The Bidder hereby agrees to:

- 1. Enter into a contract, if this proposal is selected, in the form approved by the Jurisdiction, provide proof of registration with the lowa Division of Labor in accordance with Chapter 91C of the lowa Code, and furnish a performance, maintenance, and payment bond; and
- 2. Forfeit bid security, not as a penalty but as liquidated damages, upon failure to enter into such contract and/or furnish said bond; and
- 3. Commence the work on this project within 10 days of the date specified on the Notice to Proceed; and
- 4. Substantially complete the project on or before 40 Working Days; and
- 6. Pay liquidated damages for noncompliance with said completion provisions at the rate of \$500 for each calendar day thereafter the work remains incomplete.

#### PROPOSAL: PART E - NON-COLLUSION AFFIDAVIT

The Bidder hereby certifies:

- 1. That this proposal is not affected by, contingent on, or dependent on any other proposal submitted for any improvement with the Jurisdiction; and
- 2. That no individual employed by the Bidder has employed any person to solicit or procure the work on this project, nor will any employee of the Bidder make any payment or agreement for payment of any compensation in connection with the procurement of this project; and
- 3. That no part of the bid price received by the Bidder was or will be paid to any person, corporation, firm, association, or other organization for soliciting the bid, other than the payment of their normal compensation to persons regularly employed by the Bidder whose services in connection with the construction of the project were in the regular course of their duties for the Bidder; and
- 4. That this proposal is genuine and not collusive or sham; that the Bidder has not colluded, conspired, connived or agreed, directly or indirectly, with any bidder or person, to submit a sham bid or to refrain from bidding, and has not in any manner, directly or indirectly, sought, by agreement or collusion, or communication or conference, with any person, to fix the bid price of the Bidder or of any other bidder, and that all statements in this proposal are true; and

Division Street Shared Use Path Wilton, Iowa ADDENDUM #1

5. That the individual(s) executing this proposal have the authority to execute this proposal on behalf of the Bidder.

#### PROPOSAL: PART F – ADDITIONAL REQUIREMENTS

The Bidder hereby agrees to comply with the additional requirements listed below which are included in this proposal and identified as proposal attachments:

	ITEM NO.	DESCRIPTION OF ATTACHMENT				
	1.	Bidder Statu Business	s Form and	Worksheet:	Authorization t	o Transact
	2.	Bid Bond (sul	bmitted in a so	eparate, sea	led envelope)	
PROPOSAL	.: PART G – ID	ENTITY OF BIDDER				
The Bidder s Submitted by	shall indicate whe y a/an:	ther the bid is				
Individual Sole F	dual, Proprietorship			Bidde		
Partne	ership			Blade	r	
Corpo	ration			Signa	ture	
	venture: all partie te all documents	es must join-in and E	Зу	Name	e (Print/Type)	
Other				Title		
Number	shall enter its Pub	issued		Street	t Address	
Section 91C	5.5 of the Iowa Co	de.		City, S	State, Zip Code	
				Telep	hone Number	
NOTE:	The signature or signature will no	n this proposal must be a to be accepted.	an original sig	nature in ink	; copies or facsi	mile of any
Subscribed	and sworn to befo	ore me this	_ day of		, 20	
		Notary Public	c in and for	<u></u>		
		State of				

HR	Gre	en,	Inc.
Pro	iect	No.	2302607

Division Street Shared Use Path Wilton, Iowa ADDENDUM #1

County of	
My commission expires	

# PROPOSAL DIVISION STREET SHARED USE PATH WILTON, IOWA

#### PROPOSAL ATTACHMENT: PART C – BID ITEMS, QUANTITIES AND PRICES

This is a UNIT BID PRICE CONTRACT. The bidder must provide the Unit Bid Price, the Total Bid Price, and the Total Construction Cost; in case of discrepancy, the Unit Bid Price governs. The quantities shown on the Proposal Attachment: Part C – Bid Items, Quantities and Prices are approximately only, but are considered sufficiently adequate for the purpose of comparing bids. The Jurisdiction shall only use the Total Construction Cost for comparison of bids.

ITEM		LINUT	OHANTITY	UNIT	TOTAL
NO.	TORONI OFF OITE	UNIT	QUANTITY	PRICE	TOTAL
1.	TOPSOIL, OFF-SITE	CY	87	\$	\$
2.	EXCAVATION, CLASS 13	CY	87	\$	\$
3.	REMOVAL OF STRUCTURE, STORM SEWER PIPE APRON	EA	1	\$	\$
4.	REMOVAL OF KNOWN PIPE CULVERT, 15"	LF	35	\$	\$
5.	REMOVAL OF STORM SEWER, PVC, 8"	LF	32	\$	\$
6.	STORM SEWER, TRENCHED, 18", RCP	LF	22	\$	\$
7.	STORM SEWER, TRENCHED, 24", RCP	LF	188	\$	\$
8.	PIPE APRON, 24" RCP	EA	1	\$	\$
9.	INTAKE, SW-512, 24"	EA	2	\$	\$
10.	CURB AND GUTTER	LF	49	\$	\$
11.	PCC PAVEMENT SAMPLES AND TESTING	LS	1	\$	\$
12.	REMOVAL OF DRIVEWAY	SY	145	\$	\$
13.	SHARED USE PATH, PCC, 5"	SY	<mark>1,508</mark>	\$	\$
14.	SHARED USE PATH, PCC, 7"	SY	31	\$	\$
15.	DETECTABLE WARNING	SF	66	\$	\$
16.	DRIVEWAY, PAVED, PCC, 7"	SY	63	\$	\$
17.	CURB AND GUTTER REMOVAL	LF	37	\$	\$
18.	GRANULAR RESURFACING	SY	27	\$	\$
19.	TEMPORARY TRAFFIC CONTROL	LS	1	\$	\$
20.	REMOVE AND REINSTALL TRAFFIC SIGNS	EA	3	\$	\$
21.	CONVENTIONAL SEEDING, TYPE 2, SEEDING, FERTILIZING, AND MULCHING	AC	0.1	\$	\$
22.	SWPPP PREPARATION	LS	1	\$	\$
23.	SWPPP MANAGEMENT	LS	1	\$	\$
24.	CONSTRUCTION SURVEY	LS	1	\$	\$

Division Street Shared Use Path Wilton, Iowa ADDENDUM #1

ITEM NO.		UNIT	QUANTITY	UNIT PRICE	TOTAL
25.	MOBILIZATION	LS	1	\$	\$
26.	CONCRETE WASHOUT	LS	1	\$	\$
27.	LIGHT POLE RELOCATION	LS	1	\$	\$
<mark>28.</mark>	SPECIAL SUBBASE PREPARATION	SY	<mark>2,155</mark>	\$	\$
TOTAL	TOTAL ITEM 1 - 28				

NOTE: IT IS UNDERSTOOD THAT THE ABOVE QUANTITIES ARE ESTIMATED FOR THE PURPOSE OF THIS BID. ALL QUANTITIES ARE SUBJECT TO REVISION BY THE CITY. QUANTITY CHANGES WHICH AMOUNT TO TWENTY (20) PERCENT OR LESS OF THE TOTAL BID SHALL NOT AFFECT THE UNIT PRICE BID.

Bidder		

PAVEMENT

PCC

NO.

Sheets

Sheets

B.1

Sheets

D Sheets

Sheets

G.1 S Sheets

S.1

/ Sheets

C.1-2

D.1-5

A.1-2

PROJECT NUMBER

2302607


# PCC SHARED USE PATH - GRADE AND PAVE

## ALONG DIVISION STREET FROM MAURER STREET TO CYPRESS STREET

SCALES: As Noted

Refer to the Proposal Form for list of applicable specifications

Value Engineering Saves. Refer to Article 1105.14 of the Specifications.

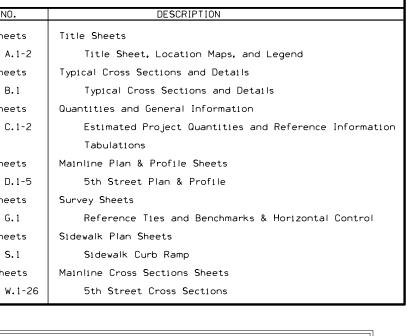

The lowa Statewide Urban Design and Specifications (SUDAS) Latest Revisions - 2023 Edition, applicable Supplemental Specifications, and Special Provisions, shall apply to construction on this project.

INDEX OF SHEETS




رم	~~~	······	······	~ <u>/1</u>
{		REVISIONS	5	<b>1</b> {
ξ	NO.	DESCRIPTION	DATE	13
ξ	1	ADDENDUM #1	2/6/2024	]{
٤				]{
٤				] }
{				<b> </b> }
اغ				<b>J</b> }
~	$\dots$			S

	MILEAGE SUMM	<b>IARY</b>	105-1 09-27-94
DIV.	LOCATION	LIN. FT.	MILES
DIVISION STREET SHARED USE PATH (STA 100+51.08 - 142+01.03)		4031.50	0.764
	TOTAL	4031.50	0.764





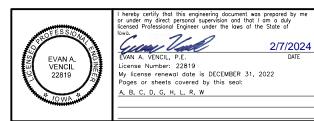


DESIGN TEAM HR Green. Inc. ENGLISH

CITY OF WILTON

MUSCATINE COUNTY

PROJECT NUMBER 2302607

SHEET NUMBER A. 1

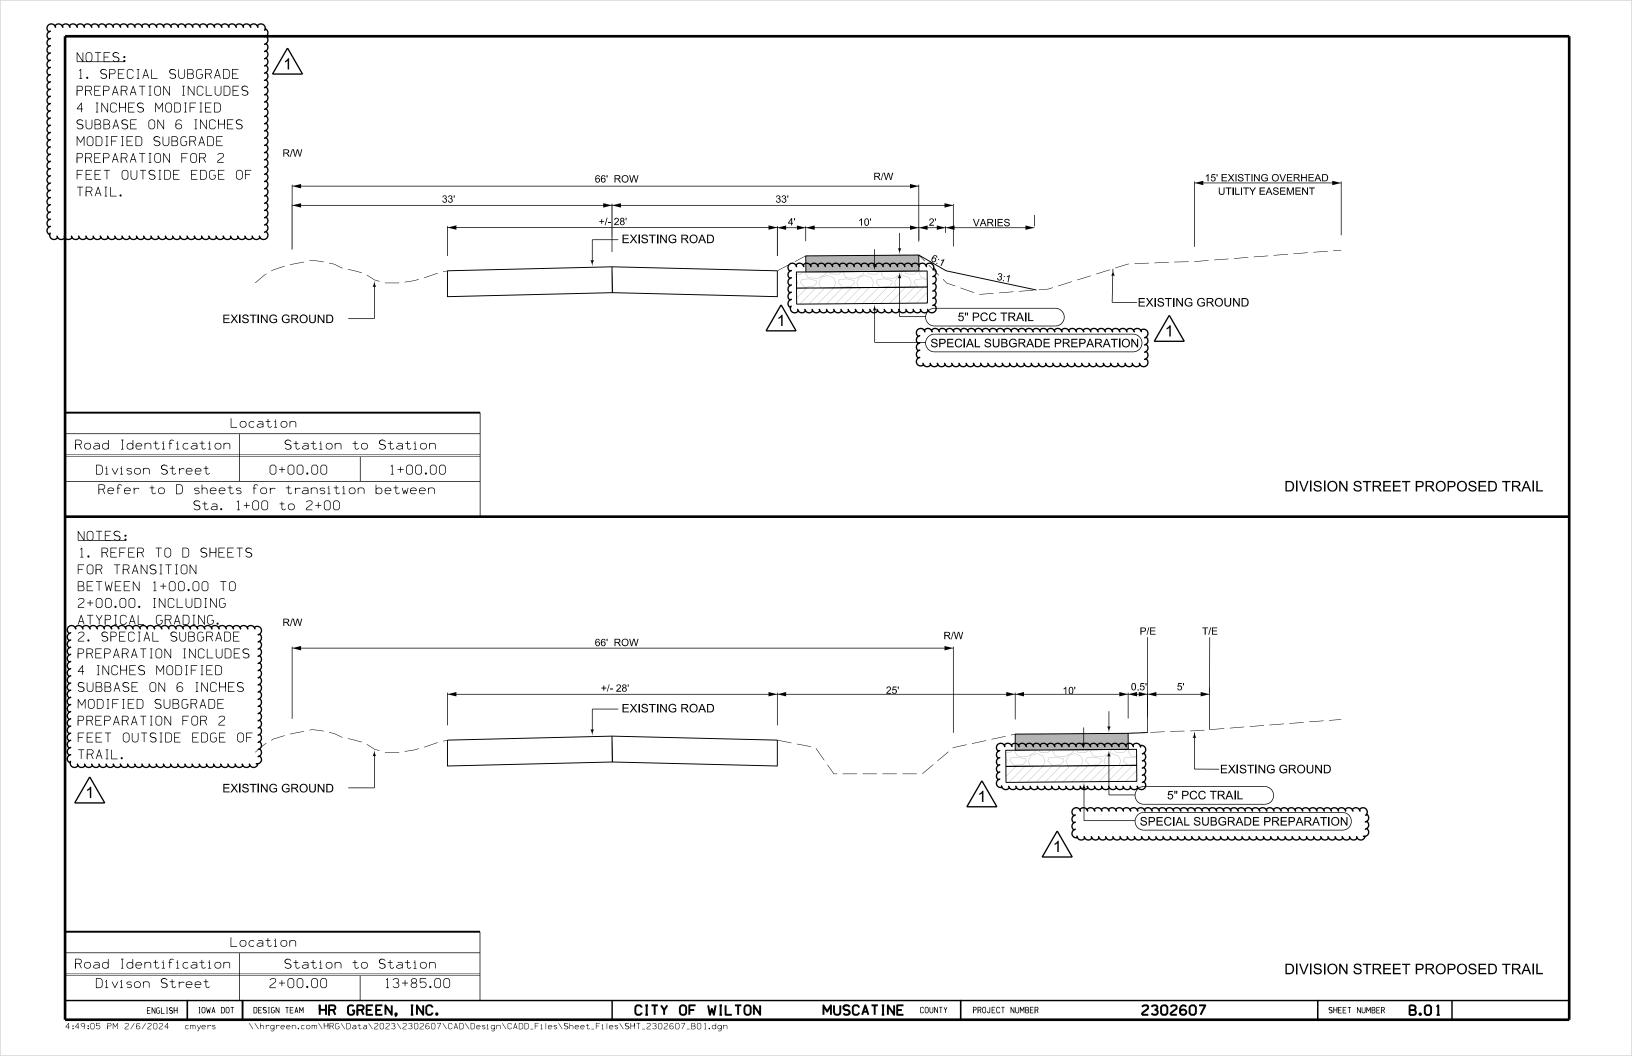

## ESTIMATED PROJECT QUANTITIES

No.	Item Code	Bid Item	Units	Total Quantity
1	2010-D	TOPSOIL, OFF-SITE	CY	87
2	2010-E	EXCAVATION, CLASS 13	CY	87
3	2010-K-1	REMOVAL OF STRUCTURE, STORM SEWER PIPE APRON	EA	1
4	2010-K-2-C	REMOVAL OF KNOWN PIPE CULVERT, 15"	LF	35
5	4020-D	REMOVAL OF STORM SEWER, PVC, 8"	LF	32
6	4030-A-1	STORM SEWER, TRENCHED, 18", RCP	LF	22
7	4030-A-1	STORM SEWER, TRENCHED, 24", RCP	LF	188
8	4030-B	PIPE APRON, 24" RCP	EA	1
9	6010-B	INTAKE, SW-512, 24"	EA	2
10	7010-E	CURB AND GUTTER	LF	49
11	7010-1	PCC PAVEMENT SAMPLES AND TESTING	LS	1
12	7030-A-3	REMOVAL OF DRIVEWAY	SY	145
13	7030-C	SHARED USE PATH, PCC, 5"	SY	1508
14	7030-C	SHARED USE PATH, PCC, 7"	SY	31
15	7030-G	DETECTABLE WARNING	SF	66
16	7030-H-1	DRIVEWAY, PAVED, PCC , 7"	SY	63
17	7040-1	CURB AND GUTTER REMOVAL	LF	37
18	7040-X	GRANULAR RESURFACING	SY	27
19	8030-A	TEMPORARY TRAFIC CONTROL	LS	1
20	8040-1	REMOVE AND REINSTALL TRAFFIC SIGNS	EA	3
21	9010-A	CONVENTIONAL SEEDING, TYPE 2, SEEDING, FERTILIZING, AND MULCHING	AC	0
22	9040-A-1	SWPPP PREPARATION	LS	1
23	9040-A-2	SWPPP MANAGEMENT	LS	1
24	11010-A	CONSTRUCTION SURVEY	LS	1
25	11020-A	MOBILIZATION	LS	1
26	11050-A	CONCRETE WASHOUT	LS	1
mism	~~~~ <del>12000</del> *~~~~	~~~~~~~~~~~~~~~~~~~~~~~~~~~~~~~~~~~~~~	mbm	<del>mm4mm</del>
28	12000-X	SPECIAL SUBBASE PREPARATION	SY	2155

		ESTIMATE REFERENCE INFORMATION
No.	Item Code	Bid Item
1	2010-D	TOPSOL, OFF-SITE
		A. PAYMENT FOR THIS ITEM SHALL BE AT PLAN QUANTITY.
		B. CONTRACTOR SHALL SPREAD TOPSOIL OVERALL DISTURBED AREAS.
2	2010-E	EXCAVATION, CLASS 13
		A. PAY FOR THIS ITEM SHALL BE AT PLAN QUANTITY REGARDLESS THE AMOUNT REQUIRED TO CONSTRUCT PER PLAN DOCUMENTS
3	2010-K-1	REMOVAL OF STRUCTURE, STORM SEWER PIPE APRON
		A. REFER TO TABULATION IN C SHEETS.
		B. REFER TO LOCATIONS IN D SHEETS.
	00401/.0.0	REMOVAL OF KNOWN PIPE CULVERT, 15"
4	2010-K-2-C	A. REFER TO TABULATION IN C SHEETS.
		B. REFER TO LOCATIONS IN D SHEETS.
		C. REMOVAL OF APRON FOOTING IF ANY SHALL BE INCLUDED WITH THIS ITEM.
		C. REMOVAL OF AFRON FOOTING IF ANY SHALL BE INCLUDED WITH THIS TIEM.
5	4020-D	REMOVAL OF STORM SEWER, PVC, 8"
		A. REFER TO TABULATIONS IN C SHEETS AND LOCATION IN D SHEETS.
6	4030-A-1	STORM SEWER, TRENCHED, 18", RCP
		A. REFER TO TABULATIONS IN C SHEETS AND LOCATION IN D SHEETS.

CITY OF WILTON

No.	ltem Code	Bid Item
7	4030-A-1	STORM SEWER, TRENCHED, 24", RCP
		A. REFER TO TABULATIONS IN C SHEETS AND LOCATION IN D SHEETS.  THIS ITEM INCLUDES THE 24" X 18" RCP TEE AS CALLED OUT ON THIS PIPE RUN AND ALL WORK REQUIRED TO INSTALL SUCH TEE.
8	4030-B	PIPE APRON, 24" RCP
		A. REFER TO TABULATIONS IN C SHEETS AND LOCATION IN D SHEETS.  B. ITEM INCLUDED AND CONTRACT SHALL INSTALL APRON FOOTING PER SUDAS FIGURE 4030.221.
9	6010-B	NTAKE, SW-512, 24"
		A. REFER TO TABULATIONS IN C SHEETS AND LOCATION IN D SHEETS.
10	7010 <b>-</b> E	CURB AND GUTTER  A. REFER TO TABULATIONS IN C SHEETS AND LOCATION IN D SHEETS.
		B. ITEM INCLUDES PAVEMENT OUT TO REMOVAL EXTENTS.
11	7010-l	PCC PAVEMENT SAMPLES AND TESTING
12	7030-A-3	REMOVAL OF DRIVEWAY
12	7030-71-3	A. REFER TO TABULATIONS IN C SHEETS AND LOCATION IN D SHEETS.
		B. INCLUDES REMOVAL OF GRANULAR AND PAVED DRIVEWAY
		CONTRACTOR SHALL MARK IN FIELD REMOVAL EXTENTS AND HAVE CONSTRUCTION INSPECTOR VERIFY
		REMOVAL EXTENTS LIMITS PRIOR TO REMOVAL.
13	7030-C	SHARED USE PATH, PCC, 5"
		REFER TO TABULATIONS IN C SHEETS AND LOCATION IN D SHEETS.      REFER TO TYPICAL SECTIONS IN B SHEETS.
14	7030-C	SHARED USE PATH, PCC, 7"
		A. REFER TO TABULATIONS IN C SHEETS AND LOCATION IN D SHEETS.  B. REFER TO TYPICAL SECTIONS IN B SHEETS.
15	7030-G	DETECTABLE WARNING
		A. REFER TO TABULATIONS IN C SHEETS AND LOCATION IN D SHEETS.     B. PROVIDE IN RED COLOR.
16	7030-H-1	DRIVEWAY, PAVED, PCC , 7"
		A. REFER TO TABULATIONS IN C SHEETS AND LOCATION IN D SHEETS.
17	7040-l	CURB AND GUTTER REMOVAL
		A. CONTRACTOR SHALL MARK IN FIELD REMOVAL EXTENTS AND HAVE CONSTRUCTION INSPECTOR VERIFY REMOVAL EXTENTS LIMITS PRIOR TO REMOVAL.
18	7040-X	GRANULAR RESURFACING
	70.07	A. GRANULAR MATERIAL SHOULD BE EXISTING MATERIAL STORED DURING REMOVAL, AND RESPREAD AND COMPACTED.
19	8030-A	TEMPORARY TRAFIC CONTROL
		A. CONTRACTOR SHALL FOLLOW SUDAS 8030.104 DURING CONSTRUCTION BETWEEN STATION 0+00.00 TO 1+75.00. AND SUDAS 8030.102 AFTER STATION 1+75.00 TO END.
		B. CONTRACTOR SHALL PROVIDE CLOSURE BARRICADE ON EACH SIDE OF ANY CLOSED DRIVEWAY.
		THIS ITEM SHALL INCLUDE ANY AND ALL MODIFICATIONS TO THE TRAFFIC CONTROL PLAN WHICH OCCUR AT
		C. THE CONTRACTOR'S ELECTIONS OR ARE NECESSARY TO ACCOMADATE THE CONTRACTOR'S MEANS AND METHODS.
20	8040-1	REMOVE AND REINSTALL TRAFFIC SIGNS
20	30+0-1	A. ITEM INCLUDES ALL HARDWARE, ANCHOR POSTS, AND SIGN POLES IF DAMAGED UPON REMOVAL OR UNREUSABLE.
21	9010-A	CONVENTIONAL SEEDING, TYPE 2, SEEDING, FERTILIZING, AND MULCHING
		A. INCLUDES ALL AREAS DISTURBED BY THE CONTRACTOR.     B. PAYMENT SHALL BE AT PLAN QUANTITY FOR THIS ITEM.
22	9040-A-1	SWPPP PREPARATION
	20.071	A. THE DISTRUBANCE LIMITS IS UNDER 1 ACRE, IN THE EVENT CONTRACTOR EXPANDS THE DISTURBANCE LIMITAND EXCEEDS AN ACRE THIS ITEM SHALL BE USED.
23	9040-A-2	SWPPP MANAGEMENT
24	11010-A	CONSTRUCTION SURVEY
25	11020-A	MOBILIZATION  THIS ITEM INCLUDES PAYMENT FOR ALL ITEMS CALLED OUT ON THE PLANS TO CONSTRUCT OR INSTALL AND  A. BOUNT HAVE A SPECIFICATION FOR ALL ITEMS.
		TO NOT HAVE A SPECIFIC LINE ITEM.

		ESTIMATE REFERENCE INFORMATION
No.	Item Code	Bid Item
26	11050-A	CONCRETE WASHOUT
27	12000-X	LIGHT POLE RELOCATION
		A. CONTROATOR SHALL PERFORM AND FIELD LOCATE EXISTING ELECTRICAL ITEM.
		B CONTRACTOR SHALL COORDINATE, COOPERATE, AND ACCOMMODATE REQUESTS OF SIMPSON MEMORIAL
		HOME IN RELOCATING LIGHT POLE.
		C. CONTRACTOR SHALL SALVAGE AND REINSTALL EXISTING FIXTURE.
		D. FOOTING PER IOWA DOT STANDARD ROAD PLAN LI-201 IS INCLUDED WITH THIS ITEM.
		CONTRACTOR SHALL REWIRE OR ADJUST LOCATION AS NECESSARY TO ACCOMMODATE EXISTING
		ELECTRICAL SERVICE.
		F. REPLACEMENT ANCHOR BOLTS, NUTS, AND PLATES SHALL BE PROVIDED.
		ITEM INCLUDES ALL OF THE ABOVE, WIRING, CONDUITS, REBAR CONCRETE, REMOVAL AND STORAGE OF
		S. EXISTING FIXTURE, ALL TOOLS, LABOR, AND EQUIPMENT NECESSARY TO PERFORM THIS WORK.
m	m	$\cdots$

28	12000-X	SPECIAL SUBBASE PREPARATION
	12000 X	THIS ITEM INCLUDES 4 INCHES OF MODIFIED SUBBASE ON 6 INCHES OF SUBGRADE PREPARATION FOR 2 FE
		B. FOR THE 4 INCHES OF MODIFIED SUBBASE CONTRACTOR SHALL FOLLOW SUDAS 2010-J FOR INCLUSIONS, PRODUCT SPECIFICATIONS, AND EXECUTION.
		FOR THE 6 INCHES OF SUBGRADE PREPARATION CONTRACTOR SHALL FOLLOW SUDAS 2010-G FOR INCLUSIONS, SPECIFIED MATERIALS, AND EXECUTION.

Location   Side   Length (LF)   Re     Division Street	
	emarks
0+00.00 0+12.75 BOTH 25	
14+03.23 14+05.23 BOTH 24	
TOTAL 49 LF	

DRIVEWAY, PCC											
Location		Area (SF)	Area (SY)	Remarks							
Division Street											
Sta 04+59.11 to Sta 04+88.49	BOTH	569.6	63.3	PCC 7"							
		TOTAL 7"	63	SY							

SIDI WALK, PCC, 5 IN.										
Location		Δrea (SL)	Area (SY)	Remarks (SL)						
	Division	Street								
Sta. 0+00.00 to Sta. 1+73.11	LT	1726.3	191.9							
Sta. 2+01.14 to Sta. 4+67.76	LT	2644.4	293.9							
Sta. 4+84.70 to Sta. 7+(M.02	11	2216.0	246.3							
Sta. 7+28.80 to Sta. 7+/8.56	- 11	497.9	55.4							
Sta. 8+02.48 to Sta. 10+88,90	LT	2864.2	318.3							
Sta. 10±30 to Sta. 10±35,85	RT	405.0	45.1							
Sta. 11+13.99 to Sta. 14+02.63	LT	3208.7	356.6	BOTH SIDES OF CYPRESS						
TOTAL			1508	SY						

	DETECT	TABLE WAR	NING									
Location		Area (SF)	Remarks									
Division Street												
0+05.58		25.6										
14+04.28		40.0	BOTH SIDES									
T	OTAL	66	SF									

SIDEWALK, PCC, 7 IN.												
Location		Area (SL) — Area (SY)	Remarks (SL)									
Division Street												
Sta. 1+72.97 to Sta. 1+99.59	LT	277.8 30.9										
TOTAL		31	SY									

REMOVAL OF GRANULAR DRIVEWAY												
Location		Area (SF)	Area (SY)	Remarks								
	Division Street											
Sta 1+73.11 to Sta 2+00.86	LT	485.4	54.0									
Sta 9+00.42 to Sta 9+54.62	R⊤	812.6	90.3									
		TOTAL	145	SY								

2302607

104-5B 06-06-17

SHEET NUMBER C.02

### STORM SEWER

* Bid It	PM					Ι																							
	INTAKES AND UTILITY ACCESSES					PIPES																							
r					Design Length, Slope and Flowlines are calculated center of structure to center of structure along CL of pipe.																								
		Ives on Standard   RIM / FG   Bottom Well		1		Intake/Utility				Bid Design	_	63	Γ1ow Li	Lines	Granular														
No. Loc	Location Station	Type or Standard			Notes	Line	Access	No.	Class Diameter	Length	n <sup>e</sup> Length	ngth Slope	iope // inlet	nlet Outlet	Back <del>f</del> ill	Pipe Plan	Notes												
		KOAU PIAN*	Road Plan*	koad Plan*	Koad Pian*	Koad Plan†	Koad Pian*	Koad Pian*	Koad Pian*	Kodu Plan	koad Pian*	KOAG PIAN*	KOAU PIAN"	Elev.	Elev.		Number	From	10		Inches	Feet	Feet	~	Elevation	Elevation	CY	Sheet No.	
1	0+14.58, 5.35° RI	SW-512	704.28			1-1			111	18	9		2.00%	/02.53	/02.69			PROVIDE SW-604 TYPE 3A											
2	0+14.75, 3.65° LT	RCP Tee	N/A	N/A	24" X 18", PER IOWA DOT DR-142 DETAIL, INCIDENTAL, PROVIDE SW-604 TYPE 3A	P-2			III	24	188		1.20%	702.60	704.42			INCIDENTAL TO 24" RCP PIPE											
3	1+56.05, 2.84' IT	RCP Tee	N/A	N/A	24" X 18", PER TÓWA DÓT DR-142 DETATI, INCIDENTAL TÓ 24" RCP PIPE	P=3			TTT	18	13		2.00%	703.97	704.24														
4	1+58.18, 10.14' RT	SW-512	706.94	N/A	PROVIDE SW-604 TYPE 3A																								
5	2+02.36, 11.12' LT	APRÓN	N/A	N/A	REMOVE EXISTING APRON AND CONNECT TO PROPOSED PIPE																								

MUSCATINE COUNTY PROJECT NUMBER